

361A Old Finch Ave. Toronto, ON M1B 5K7 www.torontozoo.com

Tel: 416-392-5900 Fax: 416-392-5934

2021-02-09

### REQUEST FOR QUOTATION CARIBOU CAFÉ – WASHROOM UPGRADES TZC T 02-2021-01 ADDENDUM #2

This addendum shall be incorporated into, and form part of TZC T 02-2021-01 and take precedence over all requirements of the previously issued bid documents including plans. This addendum must be signed by the bidder (signing officer) in the appropriate space and must be attached to the Form for submission by the bidder. This Addendum consists of two (2) pages.

### 1. Submission Deadline:

Original Submission Deadline: Revised Submission Deadline: Friday, 2021-02-12 at 12:00 p.m. local time Wednesday, 2021-02-17 at 12:00 p.m. local time

#### 2. DELETE DRAWINGS:

SHEET NUMBER	SHEET NAME	ISSUE DATE
A002	SCHEDULES	2021-01-25
M102	MECHANICAL DETAILS, LEGEND AND DRAWING	2021-01-25
	LIST	
M203	AFRICAN PAVILION PLUMBING AND HVAC	2021-01-25
	MODIFICATION	
E-2.0	ELECTRICAL PLAN BUILDING	2021-01-25
E-7.1	ELECTRICAL SINGLE LINE DIAGRAM	2021-01-25

#### **REPLACE WITH DRAWINGS:**

SHEET NUMBER	SHEET NAME	ISSUE DATE
A002	SCHEDULES	2021-02-02
M102	MECHANICAL DETAILS, LEGEND AND DRAWING	2021-02-04
	LIST	
M203	AFRICAN PAVILION PLUMBING AND HVAC	2021-02-04
	MODIFICATION	
E-2.0	ELECTRICAL PLAN BUILDING	2021-02-03
E-7.1	ELECTRICAL SINGLE LINE DIAGRAM	2021-02-03

Receipt of the Addendum shall be acknowledged as part of your submission.

The Board of Management of the Toronto Zoo reserves the right to reject any or all Tenders or to accept any quotation, should it deem such action to be in its interests.

If you have any queries regarding this matter, please contact Mr. Peter Vasilopoulos, Supervisor, Purchasing & Supply, at 416-392-5916 or by email pvasilopoulos@torontozoo.ca.

Yours truly,

Peter Vasilopoulos Supervisor, Purchasing & Supply

I/we hereby acknowledge receipt of this addendum and make allowance in my bid.

Signed (Must be Signing Officer of Firm)

Name of Firm

Date:

# ADDENDUM

Project Name:	Pavilion Washroom Renovation	Addendum #:	AD-01
Project Number:	1193059	Date:	February 5, 2021
Project Address:	200 Meadowvale Road	Client:	Toronto Zoo
	Toronto, Ontario		

The following information supplements and/or supersedes the bid documents issued for Tender on January 25, 2021.

This Addendum forms part of the contract documents and is to be read, interpreted, and coordinated with all other parts. The cost of all contained herein is to be included in the contract sum. The following revisions supersede the information contained in the original drawings and specifications issued for the above-named project to the extent referenced and shall become part thereof. Acknowledge receipt of this Addendum by inserting its number and date on the Tender From. Failure to do so may subject bidder to disqualification.

### Subject: Various Modifications

### **Description of Addendum**

- 1. The Corian finish has been revised from "Earth" to "Canyon".
- 2. Refer to attached mechanical drawings for additional information.
- 3. Refer to attached electrical drawings for additional information.
- 4. The contractor shall provide a separate price line item for the supply and install of a floor based urinals in lieu of the base contract wall based urinals.
- 5. No painting inspections from a third party are required.
- 6. All doors are to remain but repaired and refinished and all hardware shall be replaced.

Issued By

MFaula

Mark Faulds Lead Designer

TAG	QUANITY	
EQ:01	12	WATER
		CLOSE
EQ:02	5	URINAL
EQ:03	2	LAVATO
EQ:04	9	FAUCE
EQ:04	9	DRYER
EQ:04	9	SOAP D
EQ:06	2	SIDE G
EQ:07	4	REAR G
EQ:08	1	NAPKIN
EQ:09	12	SURFA
EQ:10	2	<b>BF TOIL</b>
EQ:11	10	TOILET
EQ:12	2	CHANG
EQ:13	2	KIDS PL
EQ:14	8	SHELVI
EQ:15	2	MIRRO

NOTE:

1.


CONTRACTOR TO BE AWARE THAT THE SINK ALONG WITH THE SKIRT IS PURCHASED BY THE ZOO AND TO BE INSTALLED BY CONTRACTOR.

							DOOR	SCHED	ULE	
ROOM NAME	DOOR #	WIDTH	HEIGHT	THICKNESS	DOOR MATERIAL	DOOR FINISH	FRAME MATERIAL	FRAME FINISH	FIRE RATING	
	Dot	0.45	0404	50		<b></b>		DT		
MALE VESTIBULE	D01	915	2134	50	HM	PT	HM	PT	N/A	EXISTING DOOR AND
FEMALE VESTIBULE	D02	915	2134	50	HM	PT	HM	PT	N/A	EXISTING DOOR AND
MALE WASHROOM	D03	915	2134	50	HM	PT	HM	PT	N/A	EXISTING DOOR AND
FEMALE VESTIBULE	D04	915	2134	50	HM	PT	HM	PT	N/A	EXISTING DOOR AND
MALE WASHROOM	D05	622	2134	50	HM	PT	HM	PT	N/A	EXISTING DOOR AND

WASHROOM PARTITIC	С
MANUFACTURER: PRODUCT: MATERIAL: COLOUR/FINISH: HARDWARE: MOUNTING: DOORS: THICKNESS: OPTIONS:	

				F	INISH SCHEI	DULE			
TAG	DESCRIPTION	MANFACTURER	PRODUCT NUMBER	FINISH/COLOUR	SIZE	SUPPLIER	PURCHASED BY	INSTALLED BY	NOTES
TL:01	FLOOR TILE	CENTURA	54YP6R	SAW CUT NOCE	8"x48"	CENTURA	GC	GC	
TL:02	FLOOR TILE	OLYMPIA TILE	GM.RS.TIB.EYE	TIGER EYE	12"x12"	CENTURA	GC	GC	
TL:03	WALL TILE	CENTURA	25848	COLOR MARKET - MACARON	3"x9"	CENTURA	GC	GC	INSTALL IN STAGGERED PATTERN. 3" IS HORIZONTAL
TL:04	WALL TILE	CENTURA	5291	FES - VERDE - GLOSSY	5"x5"	CENTURA	GC	GC	
TL:05	SNAKE TILE	OLYMPIA TILE	MC.MR.SND.10.HEX	SAND MATTE	10"	OLYMPIA TILE	GC	GC	
TL:06	SNAKE TILE	OLYMPIA TILE	MC.MR.TPE.10.HEX	TAUPE MATTE	10"	OLYMPIA TILE	GC	GC	
TL:07	SNAKE TILE	OLYMPIA TILE	MC.MR.DRK.10.HEX	DARK MATTE	10"	OLYMPIA TILE	GC	GC	
PT:01	CEILING PAINT	SHERWIN WILLIAMS	SW 6727	HOUSEPLANT	N/A	SHERWIN WILLIAMS	GC	GC	PROVIDE 1 COAT PRIMER, 2 COATS FINISH
PT:02	DUCTWORK PAINT	SHERWIN WILLIAMS	SW 6727	HOUSEPLANT	N/A	SHERWIN WILLIAMS	GC	GC	PROVIDE 1 COAT PRIMER, 2 COATS FINISH
PT:03	DOOR PAINT TYPE 1	SHERWIN WILLIAMS	SW 6718	OVERT GREEN	N/A	SHERWIN WILLIAMS	GC	GC	PROVIDE 1 COAT PRIMER, 2 COATS FINISH
PT:04	DOOR PAINT TYPE 2	SHERWIN WILLIAMS	SW 6720	PARADISE	N/A	SHERWIN WILLIAMS	GC	GC	PROVIDE 1 COAT GREY PRIMER, 2 COATS FINISH
PT:05	SERVICE DOOR PAINT	SHERWIN WILLIAMS	SW 6720	PARADISE	N/A	SHERWIN WILLIAMS	GC	GC	PROVIDE 1 COAT PRIMER, 2 COATS FINISH

				ENTSCHEDULE				
DESCRIPTION	MÁNUFACTÚRÈR	PRODUCT NUMBER	Ý VÝRÔDUCT Ý Ý	DIMENSIONS Y	YFINISH Y	PURCHASED BY	INSTALLED BY	Y Y NOTES Y Y
R CLOSET & BF WATER /			REFER TO MECHANICAL			GC	GC	PROVIDE BACK REST FOR ACCESSIBILE WATER CLOSETS.
ET								REFER TO MECHANICAL FOR ADDITIONAL INFORMATION.
AL (			REFER TO MECHANICAL			GC	and shared to be a set of the set	REFER TO MECHANICAL FOR ADDITIONAL INFORMATION.
FORY	SLOAN	N/A / _ / _		CUSTOM AS PER DRAWINGS	CORIAN - CANYON	QWNER		INSTALL SUPPORTS, BRACKETS, UNDERCOUNTER SKIRT,
								ETCSUPPLIED-BY THE ZOO.
ET	SLOAN	EFX200	BASYS SENSOR ACTIVATED FAUCET	N/A	CHROME FINISH	OWNER	GC	
R	SLOAN	EHD-510A	HIGH SPEED HAND DRYER	N/A	CHROME FINISH	/OWNER	GC	
DISPENSER	SLOAN	ESD400	TOUCH FREE SOAP DISPENSER	N/A		OWNER	GC	
GRAB BAR	BOBRICK	B-5898	90 DEGREE GRAB BAR	762x762mm, 32mm DIA.	SATIN FINISH PEENED	GC	GC	
GRAB BAR	BOBRICK	B-5806x24	STRAIGHT GRAB BAR	610mm LONG, 32mm DIA.	SATIN FINISH PEENED	GC	GC	
IN DISPENSER	BOBRICK	B-47069 25	SURFACE MOUNTED NAPKIN DISPENSER	725x370x180mm	STAINLESS STEEL	GC	GC	
ACE MOUNTED COAT HOOK	BOBRICK	B-635	KLUTCH DEVICE HOLDER	190x228x64mm	STAINLESS STEEL	GC	GC	
ILET PAPER DISPENSER	BOBRICK	B-2890	SINGLE JUMBO ROLL TOILET TISSUE DISPENSER	N/A	STAINLESS STEEL	GC	GC	
T PAPER DISPENSER	BOBRICK	B-2892	TWIN JUMBO ROLL TOILET TISSUE DISPENSER	N/A	STAINLESS STEEL	GC	GC	
GE TABLE	KOALA CARE	KB110-SSWM	BABY CHANGE TABLE	892x508x102mm	STAINLESS STEEL	GC	GC	
PULL DOWN STEP	STEP N WASH	N/A	STEP N WASH	N/A		OWNER	GC	RE-USE AND RE-INSTALL EXISTING
VING	CORIAN	N/A	CORIAN SOLID SLAB	511mmX305mm 🤇	CORIAN - CANYON	GC	GC	
DR	N/A	N/A	SOLID PIECE MIRROR	REFER TO DRAWINGS	MIRROR	GC	GC	WITH 4" WIDE WOOD BORDER

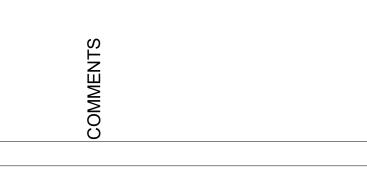

ND FRAME TO BE REPAIRED AND REFINISHED ND FRAME TO BE REPAIRED AND REFINISHED

# DOOR HARDWARE SPECIFICATIONS:

INTERIOR DOORS (D	02, D04):
DOORS:	FLEMING "H SERIES DOOR" (16 GUAGE CONTINOUS WELDED SEAMS)
FRAMES:	16 GAUGE FRAME c/w PRE-DILLED AND COUNTERSUNK ATTACHMENT HOLES
HINGES:	PRE DOOR AND FRAME FOR 4-1/2" x 4-1/2" "HAGER NRP SS HEAVY DUTY BUTT HINGES (E
KICKPLATE:	DON-JO J 301 S.S
PUSH PLATE:	DON-JO J 301 (S.S. PUSH PLATE)
PULL HANDLE:	FAUX TREE BRANCH
ADO:	HORTON 4100 SERIES c/w 6-1/4" DIAMETER PLATE. SURFACE MOUNTED AND WIRED
ELECTRIC STRIKE:	TBD
INTERIOR DOORS (D	05):
DOORS:	FLEMING "H SERIES DOOR" (16 GUAGE CONTINOUS WELDED SEAMS)
FRAMES:	16 GAUGE FRAME c/w PRE-DILLED AND COUNTERSUNK ATTACHMENT HOLES
HINGES:	PRE DOOR AND FRAME FOR 4-1/2" x 4-1/2" "HAGER NRP SS HEAVY DUTY BUTT HINGES (E
KICKPLATE:	DON-JO J 301 S.S
DOOR SWEEP:	K.N.CROWDER #W-24S
LEVER SET:	2-1/8" HOLE FOR 93 K SERIES H.D. STANLEY BEST "LEVER SET" WITH HOUSING FOR "BES
EXTERIOR DOORS (D	001, D03):
DOORS:	FLEMING "H SERIES DOOR" (16 GUAGE CONTINOUS WELDED SEAMS)
FRAMES:	16 GAUGE FRAME c/w PRE-DILLED AND COUNTERSUNK ATTACHMENT HOLES
HINGES:	PRE DOOR AND FRAME FOR 4-1/2" x 4-1/2" "HAGER NRP SS HEAVY DUTY BUTT HINGES (B
WEATHER STRIPPING	3:K.N.CROWDER #13
THRESHOLD:	K.N. CROWDER #CT-11
DOOR SWEEP:	K.N.CROWDER #W-24S
VINYL CAPS:	TOP OF DOOR RAIN CAP
LOCKS:	2-3/4" BACKSET HOLE PRE DRILLED FOR STANLEY BEST SERIES LOCKS
KICKPLATE:	DON-JO J 301 S.S
PUSH PLATE:	DON-JO J 301 (S.S. PUSH PLATE)
PULL HANDLE:	FAUX TREE BRANCH
ADO:	HORTON 4100 SERIES c/w 6-1/4" DIAMETER PLATE. SURFACE MOUNTED AND WIRED
DEADBOLT:	TUBLAR DEADBOLT, BEST 83T 7S-STK-626, 1200mm HIGH ON CENTRE
ELECTRIC STRIKE:	TBD


ION SPECIFICATION

- BOBRICK DURA LINE
- SOLID PHENOLIC CELLO 0811 FH. FINAL COLOUR TO BE DECIDED BY THE ZOO INSTITUTIONAL
- CEILING HUNG
- GAP-FREE CONCEALED HINGES 19mm
- OCCUPIED/UNOCCUPIED DOOR LOCK WITH UNLOCK FROM EXTERIOR (OCCUPANCY INDICATOR)

(BB1199) OR "STANLEY HINGES (FBB 199-NRP 32D). THREE PER DOOR

S (BB1199) OR "STANLEY HINGES (FBB 199-NRP 32D). THREE PER DOOR BEST 7-PIN IC-CORE", #15 LEVER WITH "C" ROSE, 626 FINISH.

S (BB1199) OR "STANLEY HINGES (FBB 199-NRP 32D). THREE PER DOOR

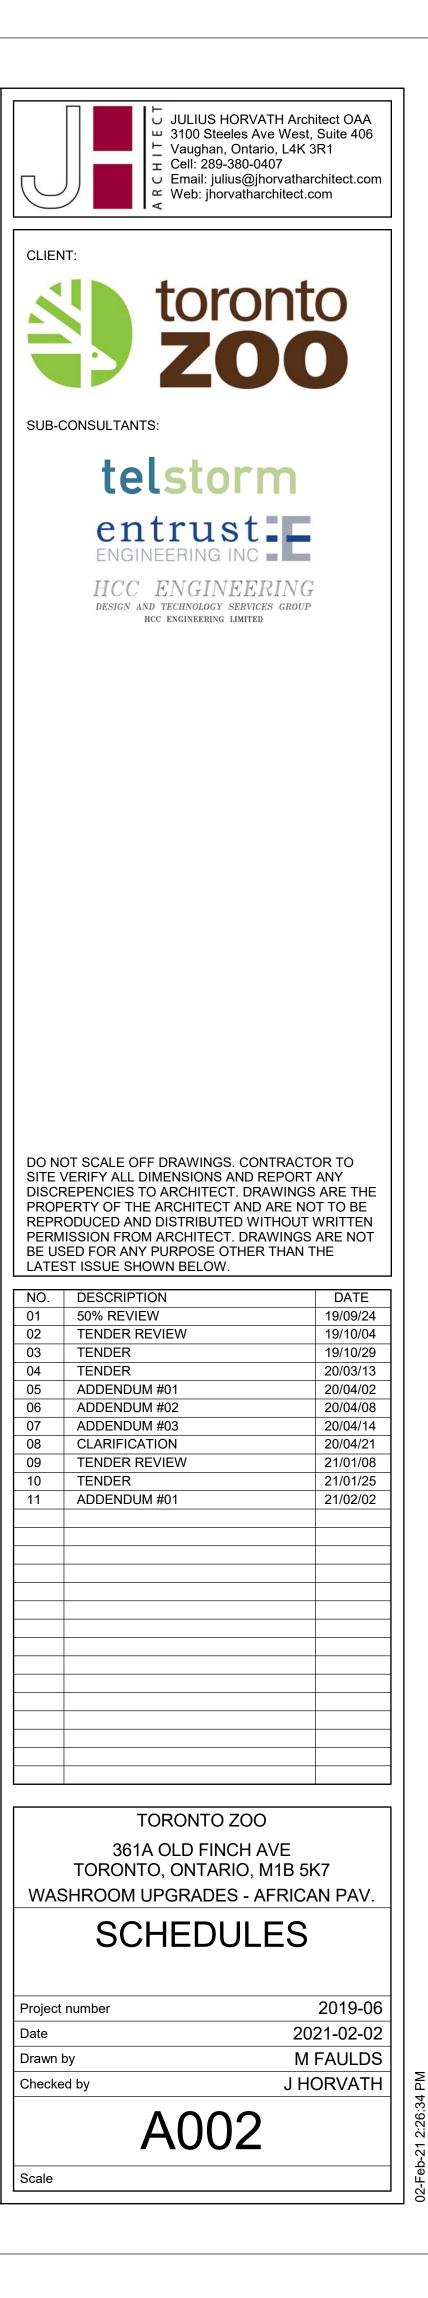

# EXISTING & DEMOLITION KEY NOTES:

- PLUMBING: (1) DEMOLISH LAVATORY C/W FAUCETS, ISOLATION VALVES & ALL ACCESSORIES; DEMOLISH SANITARY PIPE IN WALL DN TO MAIN & CAP; MODIFY SERVICE (DCW+ DHW+ VENT) TO RECEIVE NEW FIXTURE.
- $\langle \mathbf{2} \rangle$  demolish existing floor drain & clean out.
- 3 DEMOLISH FLOOR/WALL MOUNTED URINAL/WATER CLOSET C/W ISOLATION VALVES & ALL ACCESSORIES; MODIFY SERVICES (DCW+ VENT) TO RECEIVE NEW FIXTURE.
- DEMOLISH FLOOR MOUNTED WATER CLOSET C/W ISOLATION VALVES & ALL ACCESSORIES CAP 100Ø (APPR.) SANITARY BELO SLAB COORDINATE SLAB/FLOOR
- REPAIR WITH ARCH. DRAWINGS.
   APPROXIMATE SIZE, LOCATION, QUANTITY OF EXISTING SANITARY LINE. CONTRACTOR SHALL POWER FLUSH AND CAMERA INSPECT FOR SIZE & CONDITION OF ALL EXISTING
- SANITARY LINES. REPORT FINDING TO ENGINEER. ( $\hat{\mathbf{6}}$ ) DEMOLIS 100Ø (APPR.) BURIED SANITARY PIPE BACK TO MAIN CAP COORDINATE
- SLAB/FLOOR REPAIR WITH ARCH. DRAWINGS.  $\overline{(7)}$  EXISTIN 250 D 630 DC LINE DN TO BASEMENT.
- EXISTING DCW INCOMING MAIN, CONTRACTOR SHALL CONFIRM BACKFLOW DEVICE CODE COMPLIANCE.
- $\langle \widehat{\mathbf{9}} \rangle$  demolish mixing value C/W panel & accessories, modify connection to receive New.
- (10) EXISTING DCW & DHW LINES TO REMAIN.
- 1 EXISTING NATURAL GAS DOMESTIC HOT WATER TANK IN BASEMENT.
- APPROXIMATE SIZE, LOCATION, QUANTITY OF EXISTING SANITARY LINE. DEMOLISH ALL EXISTING BURIED SANITARY LINE AND MODIFY CONNECTIONS AS REQUIRED TO RECEIVE NEW BURIED SANITARY LINE.
- (13) CONTRACTOR SHALL PREPARE FLOOR (INCLUDING X-RAY SCANNING TO CONFIRM SAN. PIPE LOCATIONS, SLAB CUTTING, EXCAVATION/TRENCHING, DISPOSAL ETC,.) TO ACCOMMODATE NEW SANITARY PIPE INSTALLATION.

# EXISTING & DEMOLITION KEY NOTES:

- HVAC
- $\langle 1 \rangle$  Demolish Supply/Return/transfer grille.  $\langle 2 \rangle$  Demolish Electric Heater C/W Wiring.
- DEMOLISH CEILING HUNG MAKE-UP AIR UNIT C/W CONTROLS, COMBUSTION AIR INTAKE
   & FLUE VENT.
- (4) DEMOLISH THERMOSTAT AT H/L C/W WIRING.
- $\langle \mathbf{5} \rangle$  demolish insulated exhaust duct up through roof.
- (6) DEMOLISH EXHAUST FAN AT CEILING LEVEL.
- $\langle \overline{7} \rangle$  DEMOLISH FRESH AIR INTAKE DUCT C/W DAMPER & FRESH AIR LOUVER.
- $\langle 8 \rangle$  EXISTING NATURAL GAS PIPE TO REMAIN.  $\langle 9 \rangle$  DEMOLISH EXHAUST DUCTWORK. COORDINATE WALL REPAIR WITH ARCH.

# MODIFICATION KEY NOTES:

- PLUMBING. INSTALL O NER SUPPLIED TROU SINK AS PER SC EDULE PRO IDE 50Ø SAN. DN TO 100Ø (APPR.) EXISTIN SANTARY MAIN RECONNECT SER ICE (DC D ENT)
- (2) PRO IDE ALL MOUNTED URINAL (UR-1) AS PER SC EDULE PRO IDE 100Ø SAN. DRAIN DN TO NE 100Ø (APPR.) SANITARY MAIN RECONNECT SER ICES (DC ENT).
- (3) PROVIDE FLOOR MOUNTED WATER CLOSET (WC-1, WC-3) AS PER SCHEDULE IN SIMILAR LOCATION; RECONNECT SERVICES (DCW+ SANITARY+ VENT).
- (4) PRO IDE ALL MOUNTED ATER CLOSET ( C-2 C-4) AS PER SC EDULE PRO IDE 1000
- SAN. DRAIN DN TO 100Ø NE SANITARY MAIN RECONNECT SER ICES (DC ENT).  $\overline{(5)}$  PROVIDE THERMOSTATIC MIXING VALVE (MV-1) IN SAME LOCATION AS PER SCHEDULE;
- RECONNECT SERVICES (DCW+ DHW+ TEMPERED WATER).
- **(6)** PROVIDE DCW, DHW, DHWR INSULATION FROM BUILDING CONNECTION TO ALL SERVICES IN WASHROOM; REMOVE & REPLACE ANY EXISTING DAMAGED INSULATION.
- **7** PRO IDE 20Ø DOMESTIC OT ATER RE-CIRCULATION LINE CONNECT TO EXISTIN DOMESTIC HOT WATER LINE.
- $\langle \mathbf{8} \rangle$  provide DCW line C/W insulation.
- (9) EXISTING INSULATION IS SUSPECT OF ASBESTOS. CONFIRM AND COMPLETE ABATEMENT PRIOR TO PLUMBING DEMOLITION, BY OTHERS.
- 10 PROVIDE FLOOR DRAIN C/W TRAP PRIMER, CLEAN OUT AND ALL ACCESSORIES FOR A FULLY FUNCTIONAL SYSTEM.
- (11) PROVIDE NEW BURIED SANITARY LINES TO MATCH EXISTING DESIGN (SIZE, LOCATION, QUANTITY, ETC). COORDINATE SLAB/FLOOR REPAIR WITH ARCH. DRAWINGS.

# MODIFICATION KEY NOTES:


- HVAC:  $\langle 1 \rangle$  PROVIDE THERMOSTAT C/W WIRING AT ACCESSIBLE HEIGHT.
- PRO IDE Ø200 EX AUST DUCT UP T ROU ROOF AND TRANSITION TO Ø300. TERMINATE
   WITH GOOSE NECK AT MIN. 3048mm/10FT. AWAY FROM ANY FRESH AIR INTAKE INCLUDING OPERABLE WINDOWS.
- 3 PROVIDE BLOWER TYPE EXHAUST FAN AT H/L TIGHT TO SLAB; MODIFY EXISTING EXHAUST DUCTWORK TO ALLOW FOR UNIT INSTALLATION. CONTRACTOR SHALL RELOCATE EXISTING FIRE ALARM IF REQUIRED; SITE VERIFY SPACE AVAILABILITY AND UNIT ORIENTATION PRIOR TO PURCHASE.
- MAKE-UP AIR UNIT/ EXHAUST FAN SHALL BE OPERATED BY SCHEDULE BASED (24 /7 PROGRAMMABLE THERMOSTAT/ELECTRONIC 24/ 7 WEEKLY TIMER) C/W MANUAL OCCUPANCY OVERRIDE
- **(5)** PROVIDE CEILING HUNG MAKE-UP AIR UNIT PER SCHEDULE AT 510MM FROM U/S OF SLAB C/W INSULATED FRESH AIR INTAKE DUCTWORK & VENTING UP THROUGH ROOF. MODIFY & RE-CONNECT EXISTING SUPPLY DUCTWORK TO SUIT NEW INSTALLATION. CONTRACTOR SHALL COORDINATE DOOR FRAME DEMOLISHING WITH ARCH AND SITE VERIFY SPACE AVAILABILITY PRIOR TO PURCHASE.
- **6** PROVIDE SCENT AIR SYSTEM PER SCHEDULE, OPERATED BY SCHEDULE BASED. COORDINATE FRAGRANCE TYPE, UNIT COLOR & LOCATION WITH TZ PRIOR TO PURCHASE.
- 7 PROVIDE SUPPLY /RETURN GRILLE. MODIFY EXISTING DUCTWORK TO SUIT NEW GRILLE
- INSTALLATION; COORDINATE WALL/CEILIING REPAIR WITH ARCH. DRAWINGS.
- **8** PROVIDE NATURAL GAS PIPING C/W SUPPORT TO CSA B149 STANDARD. **9** PROVIDE 150mm DEEP DRAINABLE LOUVER, EXTRUDED ALUMINUM, 0.164 SQ.M (1.76 SQ.FT)
- FREE AREA C/W WITH BIRD SCREEN, INSECT SCREEN, BACKDRAFT DAMPER, SIMILAR TO VENTEX 2430/2435 OR EQUIVALENT, COORDINATE LOUVER SIZE (610mmX610mm OR 508mmX712mm) WITH EXISTING OPENING. CONTRACTOR SHALL DEMOLISH/REPAIR WALL TO ACCOMMODATE NEW LOUVER INSTALLATION.
- (10) CAP EXISTING EXHAUST AIR CONNECTION AT CEILING LEVEL.
- (11) PROVIDE DOOR MOUNTED TRANSFER GRILLE; COORDINATE INSTALLATION WITH ARCH. DRAWINGS.
- (12) PROVIDE ELECTRIC HEATER PER SCHEDULE.
- (13) PROVIDE NEW BELT AND PULLEY FOR EXISTING SIDE WALL MOUNTED EXHAUST FAN AS REQUIRED TO MEET AIRFLOW PER SCHEDULE.
- 14) PROVIDE SIDE WALL MOUNTED EXHAUST FAN AT ~ 7" FT FROM FFL C/W EXHAUST DUCTWORK. CONTRACTOR SHALL SITE VERIFY SPACE AVAILABILITY AND COORDINATE EXACT LOCATION OF WALL OPENING (318MMX318MM) WITH ARCH. AND EXISTING SERVICES PRIOR TO PURCHASE.
- (15) CONTRACTOR SHALL COORDINATE WITH ARCH TO PROVIDE MINIMUM 25MM DOOR UNDERCUT. (16) MOUNT EXHAUST GRILLE ON U/S OF NEW EXHAUST DUCTWORK.


CONT	NTRACTOR SHALL REFERENCE "TENDER" COLUMN IN SCHEDULES TO IDENTIFY EQUIPMENT INCLUDED IN THIS TENDER															
	DOMESTIC HOT WATER TANK SCHEDULE     SYMBOL     DESC															
TAG	TENDER	MANUF.	MODEL Q	UANTITY	-1(4H1					EIGHT 4M/IN)	DIAMETE (MM/IN	NOTES				EXISTING TO
<del>DHWT-1-</del>	CARIDOU CAFE	AO SMITH	BTRC365		KG) (L	(LP+	H) (K)	)7 120/1/	, ,	·II·I/ IIV)		2		<del>~                                    </del>		EXISTING TO DEMOLISHED FUTURE PHAS
1. NEW 2. EXISTI	NG														_	FLEX DUCT
						AIR UNIT S	SCHEDU	JLE								CONTROL WIF
TAG	TENDER M	ANUF. MODEL	SUPPLY AIR ESP	kW RPM I	GAS HEATIN	WEIGHT VUT (kg)	DIMENS L X W X H			ECTRICAI	_ SERVIC	A NOTES				DOMESTIC CC
MUA_1 (		NGA 5125	(L/s) (kPA)	0.56 1250	(kW) (kW		1663X584	(1215 MERV 8		/1/60	(AMF	,				DOMESTIC HO
1. NEW 2. EXISTI	NG															CHILLED WAT
3. INDOO 4. MOTOR	R HANGING CRADI	E C/W VIBRATIO	ON ISOLATORS.											— CHWR		CHILLED WAT
						T FAN SCI		DIMENSION		МОТ	OR			CD		CONDENSATE FIRE LINE
TAG	TENDER	MANUF.	MODEL	QTY (kg)	WHEEL DI (mm)	A. MIN. FLOW (L/s)	ESP (kPA)	W X H X D (mm)	RPM	WATTS	5 VOLT. (V/ /		S	SAN		SANITARY
	CARIDOU CAFE	CANARM	P20T10035D	-i - 16		<del>310</del>	<del>0.13</del>	390X396X51-	1725	240	115/1	<del>/60 5.2 1, 3, 5, 6</del>	-	SAN -		SANITARY - B STORM
EF-2 A	RICAN PAVILION	GREEN HECK	CWB-140-LM DG-QD	1 -	-	640	0.1	-	1105	186	-	- 2		— – ST –		STORM - BELC
-EF-3	CARIBOU CAFE	OREEN HECK	CUE 636 VG	1 14		205	0.13	301X550X550	1633	75	115/1	./60 2.6 1, 3, 1, 6	-			VENT PIPE RISE
1. NEW 2. EXISTI														C	-	PIPE DROP
4. ALUMI	E SPEED DIRECT D NUM CONSTRUCTIO SUPPORT, HANGIN	ON, WALL BRACK			ON TO FAN \	WITH 150MM N	1IN. NEOPR		CONNEC	TIONS.						TEE DROP
6. BACKD	RAFT DAMPER.													[	_	САР
	TENDED			WEIGHT	COVERAGE		DIMEN		ECTRICA			NOTEC				UNION
TAG	TENDER M	ANUF. M	10DEL QT	(kg)	(SQ.M)	DISPERSIO	(m		( //	/Hz)		NOTES				PUMP FLOW ARROW
SAS-1 NOTES:	ALL AR	OMA360 VAN	GOGH360 1	1 6.6	75	HVAC (OR) STANDALON		0X330 14	120/	1/60 1,	2, 3					GATE VALVE
1. NEW 2. STAND	ALONE, WALL-MO					)TTLE. PROGRA	AMMABLE L	CD USER INTER	FACE. E	KTERNAL	HVAC C	ONNECTOR & TUBING, 12V	,	-161-		BALL VALVE
POWER AI	DAPTOR.													(T) (H)		THERMOSTAT HUMIDISTAT
TAG	TENDER	MANUF.	MODEL	SYSTEM		N TANK S	TANK VOLUME	ACCEPTANC VOLUME		ENSION D X		NOTES		(0)		CARBON DIO
EXP 1		BELL &		DOMEST	C 1	(KG)	(L)	(L) 3		mm)	- WATE	R		<u>(OS)</u>	,	OCCUPANCY S
- <u>EXP 2</u>	CARIBOU CAFE	GOSSETT BELL & GOSSETT	PTA 20V	WATER DOMESTI WATER	C 1	10	20	<u>12</u>	Ø3	<u>)543</u>	- WATE	TO BE INSTALLED VERTICA R TO BE INSTALLED VERTICA		X		BALANCING V
EXP 3		BELL & GOSSETT	PTA 42V	DOMESTI WATER	C <u>1</u>	41	66	43	Ø	06 610	- WATE - UNIT	R TO BE INSTALLED VERTICA	ALLY			CHECK VALVE BACK WATER
						TER SCHED	ULE	MOTOR								VALVE ASSEM
TAG	TENDER	TYPE	MANUFACTU MODEL			DIMENSION X H X D (mm)	QTY I	NSTALLATION	VOLT/ (V/ /	AGE	VEIGHT (kg)	NOTES		у [][]		GLOBE VALVE
FFH-1	AFRICAN PAVILIC	FURCED	STELPRO/RW	/F2008	2	220X435X80	2	WALL	208/1	./60	2.7	-1,3,4,5		F	D	FLOOR DRAIN
UH-1 BBH-1	AFRICAN PAVILIC	BASE	STELPRO/RUH			332X300X305	2	CEILING	208/1		9.0	-2,4,5		Ŷſ		P-TRAP
BBH 2	EDUCATION	BOARD BASE BOARD	STELPRO/B		0.5	708×150×65	<u> </u>	WALL	120/1		3.0	- 1,4,5	`			
1 EATE	CE NOTES: R S ALL BE SURFA	CE MOUNTED												TAG	C.W	/. H.W
3. C/W SU 4. C/W BU	R SHALL BE CEILIN JRFACE CABINET; JILT IN THERMOST	AT;												WC-1	25m	m -
5. CONTR	ACTOR SHALL COC	ORDINATE COLO	UR WITH ARCH.	PRIOR TO PU										WC-2 WC-3	25m 25m	
DWG NO M100	. TENDER		ANICAL SPECIFI		DRAWIN	IG LIST SC	DESCR	IPTION						WC-4	25m	
M100 M101 M102	ALL	MECHA	ANICAL SPECIFI	CATIONS										UR-1	19m	m -
M102	ALL			·										TS-1	-	-
<u>-11200</u>	CARIBOU CAFE	CARIB CARIB	OU CAFE PLUME	BING & HVAG		N								FD-1 MV-1	- 19m	- m 19mr
M202 M203	AFRICAN PAVIL		AN PAVILION PL AN PAVILION PL													
<u></u>	EDUCATION EDUCATION	2000,	TION PLUMBIN			IFICATION							• •			
TAG	TENDER	PRODUCTS				$\sim$	DEC	CRIPTION		PLUM	1BING	FIXTURE SCHEDULE		$\frown$		
WC-1	ALL	TOILET	SLOAN, F	FLUSHOMETEI D, FLOOR OU	R ASSEMBLY	# 186 ESS, W	ATER CLOS	ET# 2172029,	432 MM OWL, SII	HIGH TO PHON JE	DILET, VI T FLUSH	TREOUS CHINA, FLOOR ACTION.	POWERE		CAL OV	O CHROME FIN
WC-2	WITH ALL BRASS BOLTS AND WITH RUBB SLOAN, FLUSHOMETER ASSEMBLY# 186 ESS, WATER CLOSET# 2102459, WHITE VITREOUS CHINA, WALL MOUNTED, WALL SLOAN # 186 ESS, POLISHED CHROME FIN															
WC-2	ALL	TOILET		-		$\asymp$					DILET, VI	TREOUS CHINA, FLOOR	COUPEIR	65. <u> </u>		CHROME FIN
WC-3	ALL	TOILET										ACTION. BARRIER FREE.	POWERED	D, MECHANI	CAL OV LTS ANI	ERRIDE FLUSH D WITH RUBB
WC-4	ALL	TOILET	SLOAN, F OUTLET,	FLUSHOMETEI 4.8 L (1.28 U	R ASSEMBLY S GAL) PER	# 186 ESS, W FLUST ELONO	ATER CLOS GATED BOW	ET# 2102459, /L, SIPHON JET	WHITE V FLUSH /	/ITREOU ACTION.	S CHINA BARRIER	, WALL MOUNTED, WALL FREE.	SLDAN # POWEREI	186 ESS, PC	LISHEE	O CHROME FIN ERRIDE FLUSH DUTY TOILET S
TS-1	ALL	SINK		ER-DEC WAL		SINK, BARRIE	R FREE. CO		COORDI	NATE DI	MENSIO	N, COLOR & MATERIAL	SLOAN #	EFX-200 SIN	IGLE HA	ANDLE POLISH AP, SINK SUP
UR-1	ALL	URINAL	SLOAN, U	URINAL# 1107	009, FLUSH	OMETER ASSE	MELY# 186	ESS, WHITE VI	TREOUS	CHINA,	WALL MO	DUNTED, WALL OUTLET,	SLOAN #	186 ESS, PC	LISHE	D CHROME FIN
		THERMOSTA	MODEL: I	LAWLER 801-	RB-86506, T	HERMOSTATIO	C, VALVE SH	HALL CONTROL					COUPLIN	GS.		WITH LOCK, C
MV-1	ALL	MIXING VAL	VE IUPSIDE			TEMP. RAN E VALVE ON HO			⊢110 F	125PSI	BRON E	BODY STAINLESS				
	TOR SHALL COOR	DINATE WITH M	ANUFACTURER	TO CONFIRM	FLUSHOMET	ER COMPATIB	ILITY WITH	I PLUMBING FIX	KTURE PF	RIOR TO	PURCHA	SE.				

				LEGEND
CRIPT	ION		IBOL	DESCRIPTION
			<u>v)</u>	WATER METER
D REM	AIN		 )	CLEANOUT CLEANOUT - UPRIGHT
) BE			5	HOSE BIBB
D			~	
SE 2		<u> </u>	E)	FIRE EXTINGUISHER
				SPRINKLER - PENDANT HANGING
			) 7	SPRINKLER - UPRIGHT EXPOSED SPRINKLER - SIDEWALL
IRE				FIRE HOSE CABINET
ע ק וס:	VATER			FIRE HOSE CABINET - RECESSED
			_	FIRE HOSE CABINET - SURFACE MOUNTED
		Į Į	Т	TEMPERATURE GAUGE
IOT W	ATER			2-WAY CONTROL VALVE - DDC
TER S	UPPLY		$\overline{\mathcal{A}}$	2-WAY CONTROL VALVE - PNEUMATIC
TER R	ETURN			
e dra	IN		AAV	AUTOMATIC AIR VENT
			AV	MANUAL AIR VENT
		Ŷ	) P	PRESSURE GAUGE
BELOV	V			RADIATOR
				BASEBOARD HEATER
LOW			$\leq$	SUPPLY DUCT - UP
			.<	SUPPLY DUCT - DOWN
				RETURN DUCT - UP
				RETURN DUCT - DOWN
				EXHAUST DUCT - UP
			×	EXHAUST DUCT - DOWN
				THERMALLY LINED DUCTWORK UNLESS INDICATED OTHERWISE
				ACOUSTICALLY LINED DUCTWORK
N		}===		ACOUSTICALLY LINED DUCTWORK (SINGLE LINE)
				FLEX DUCT CONNECTION
Т		-		AIR FLOW
			>	DUCT REDUCER
-				BALANCING DAMPER
DXIDE	SENSOR			
				SMOKE DAMPER
SENS	OR		BDD	BACK DRAFT DAMPER DIFFUSER TAG
VALVE			Y	$\overline{X}$ = TYPE: A, B, C, ETC. (REFER TO
Έ			Z	SPECIFICATIONS FOR MORE DETAIL) Y = AIR FLOW (L/s)
	ENTION			Z = FLEX DUCT SIZE (mm)
MBLY			× )	DETAIL CALLOUT X = DETAIL NUMBER/LETTER Y = DRAWING NUMBER
Έ				
N			FD	
			P)	DIFFERENTIAL PRESSURE
				SUPPLY DIFFUSER
	PLUMB	ING FIXT	JRE ROL	JGH-IN
ν.	T.W	WASTE	VENT	REMARKS
		1		

N.	T.W	WASTE	VENT	REMARKS
,	_	100m m	40m m	
	-	100m m	40m m	-
,	-	100m m	40m m	
	-	100m m	40m m	-
	-	100m m	40m m	
	13mm	50m m	-	REFER LAYOUT FOR FAUCET AND DRAIN QUANTITY
,	-	7 5m m	-	
nm	25m m	-	-	

ACCESSORIES
INISH, EXPOSED FLUSHOMETER FOR TOP SPUD TOILET, SENSOR ACTIVATE, HARDWIRE SH VALVE, PROVIDE WALL FLANGE, (SAME MATERIAL AS THE CONNECTING PIPE DRAIN), BER GASKET.
INISH, EXPOSED FLUSHOMETER FOR TOP SPUD TOILET, SENSOR ACTIVATE, HARDWIRE SH VALVE, ADJUSTABLE TOILET CARRIER C/W ALL FASTENERS, HANGERS, GASKETS &
INISH, EXPOSED FLUSHOMETER FOR TOP SPUD TOILET, SENSOR ACTIVATE, HARDWIRED SH VALVE, PROVIDE WALL FLANGE, (SAME MATERIAL AS THE CONNECTING PIPE DRAIN), BER GASKET. EXTRA HEAVY DUTY TOILET SEAT, SOLID PLASTIC WITH ANTIMICROBIAL
INISH, EXPOSED FLUSHOMETER FOR TOP SPUD TOILET, SENSOR ACTIVATE, HARDWIRE SH VALVE, ADJUSTABLE TOILET CARRIER C/W ALL FASTENERS, HANGERS, GASKETS & SEAT, SOLID PLASTIC WITH ANTIMICROBIAL SURFACE, OPEN FRONT.
SHED CHROME FINISH FAUCET, HARDWIRED-POWERED, DECK MOUNTED, INFRARED, PPORT BRACKETS.
INISH, EXPOSED FLUSHOMETER FOR TOP SPUD TOILET, SENSOR ACTIVATE, HARDWIRE SH VALVE, FIXTURE CARRIER, WALL ACCESS CLEANOUT C/W ALL FASTENERS, GASKETS &
C/W THERMOMETER, SHUTOFF VALVES & FITTING FOR A FULLY FUNCTIONAL SYSTEM.

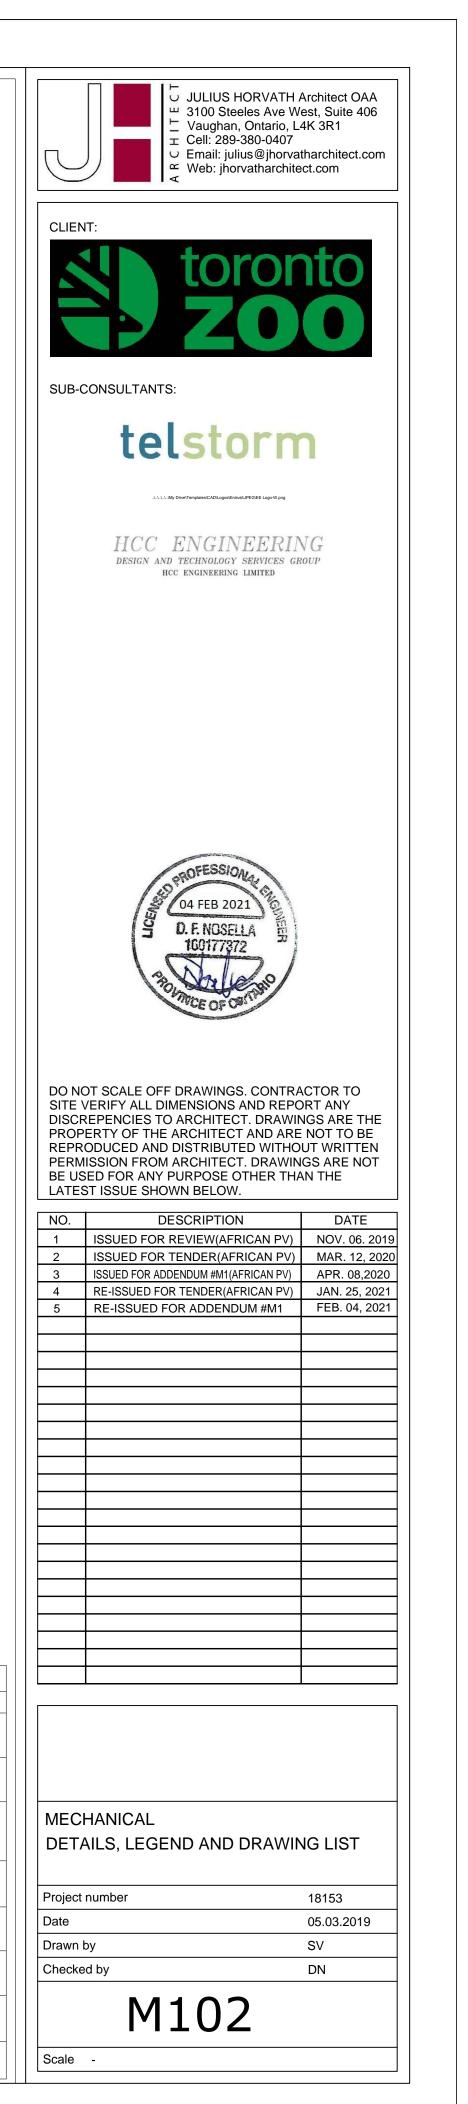

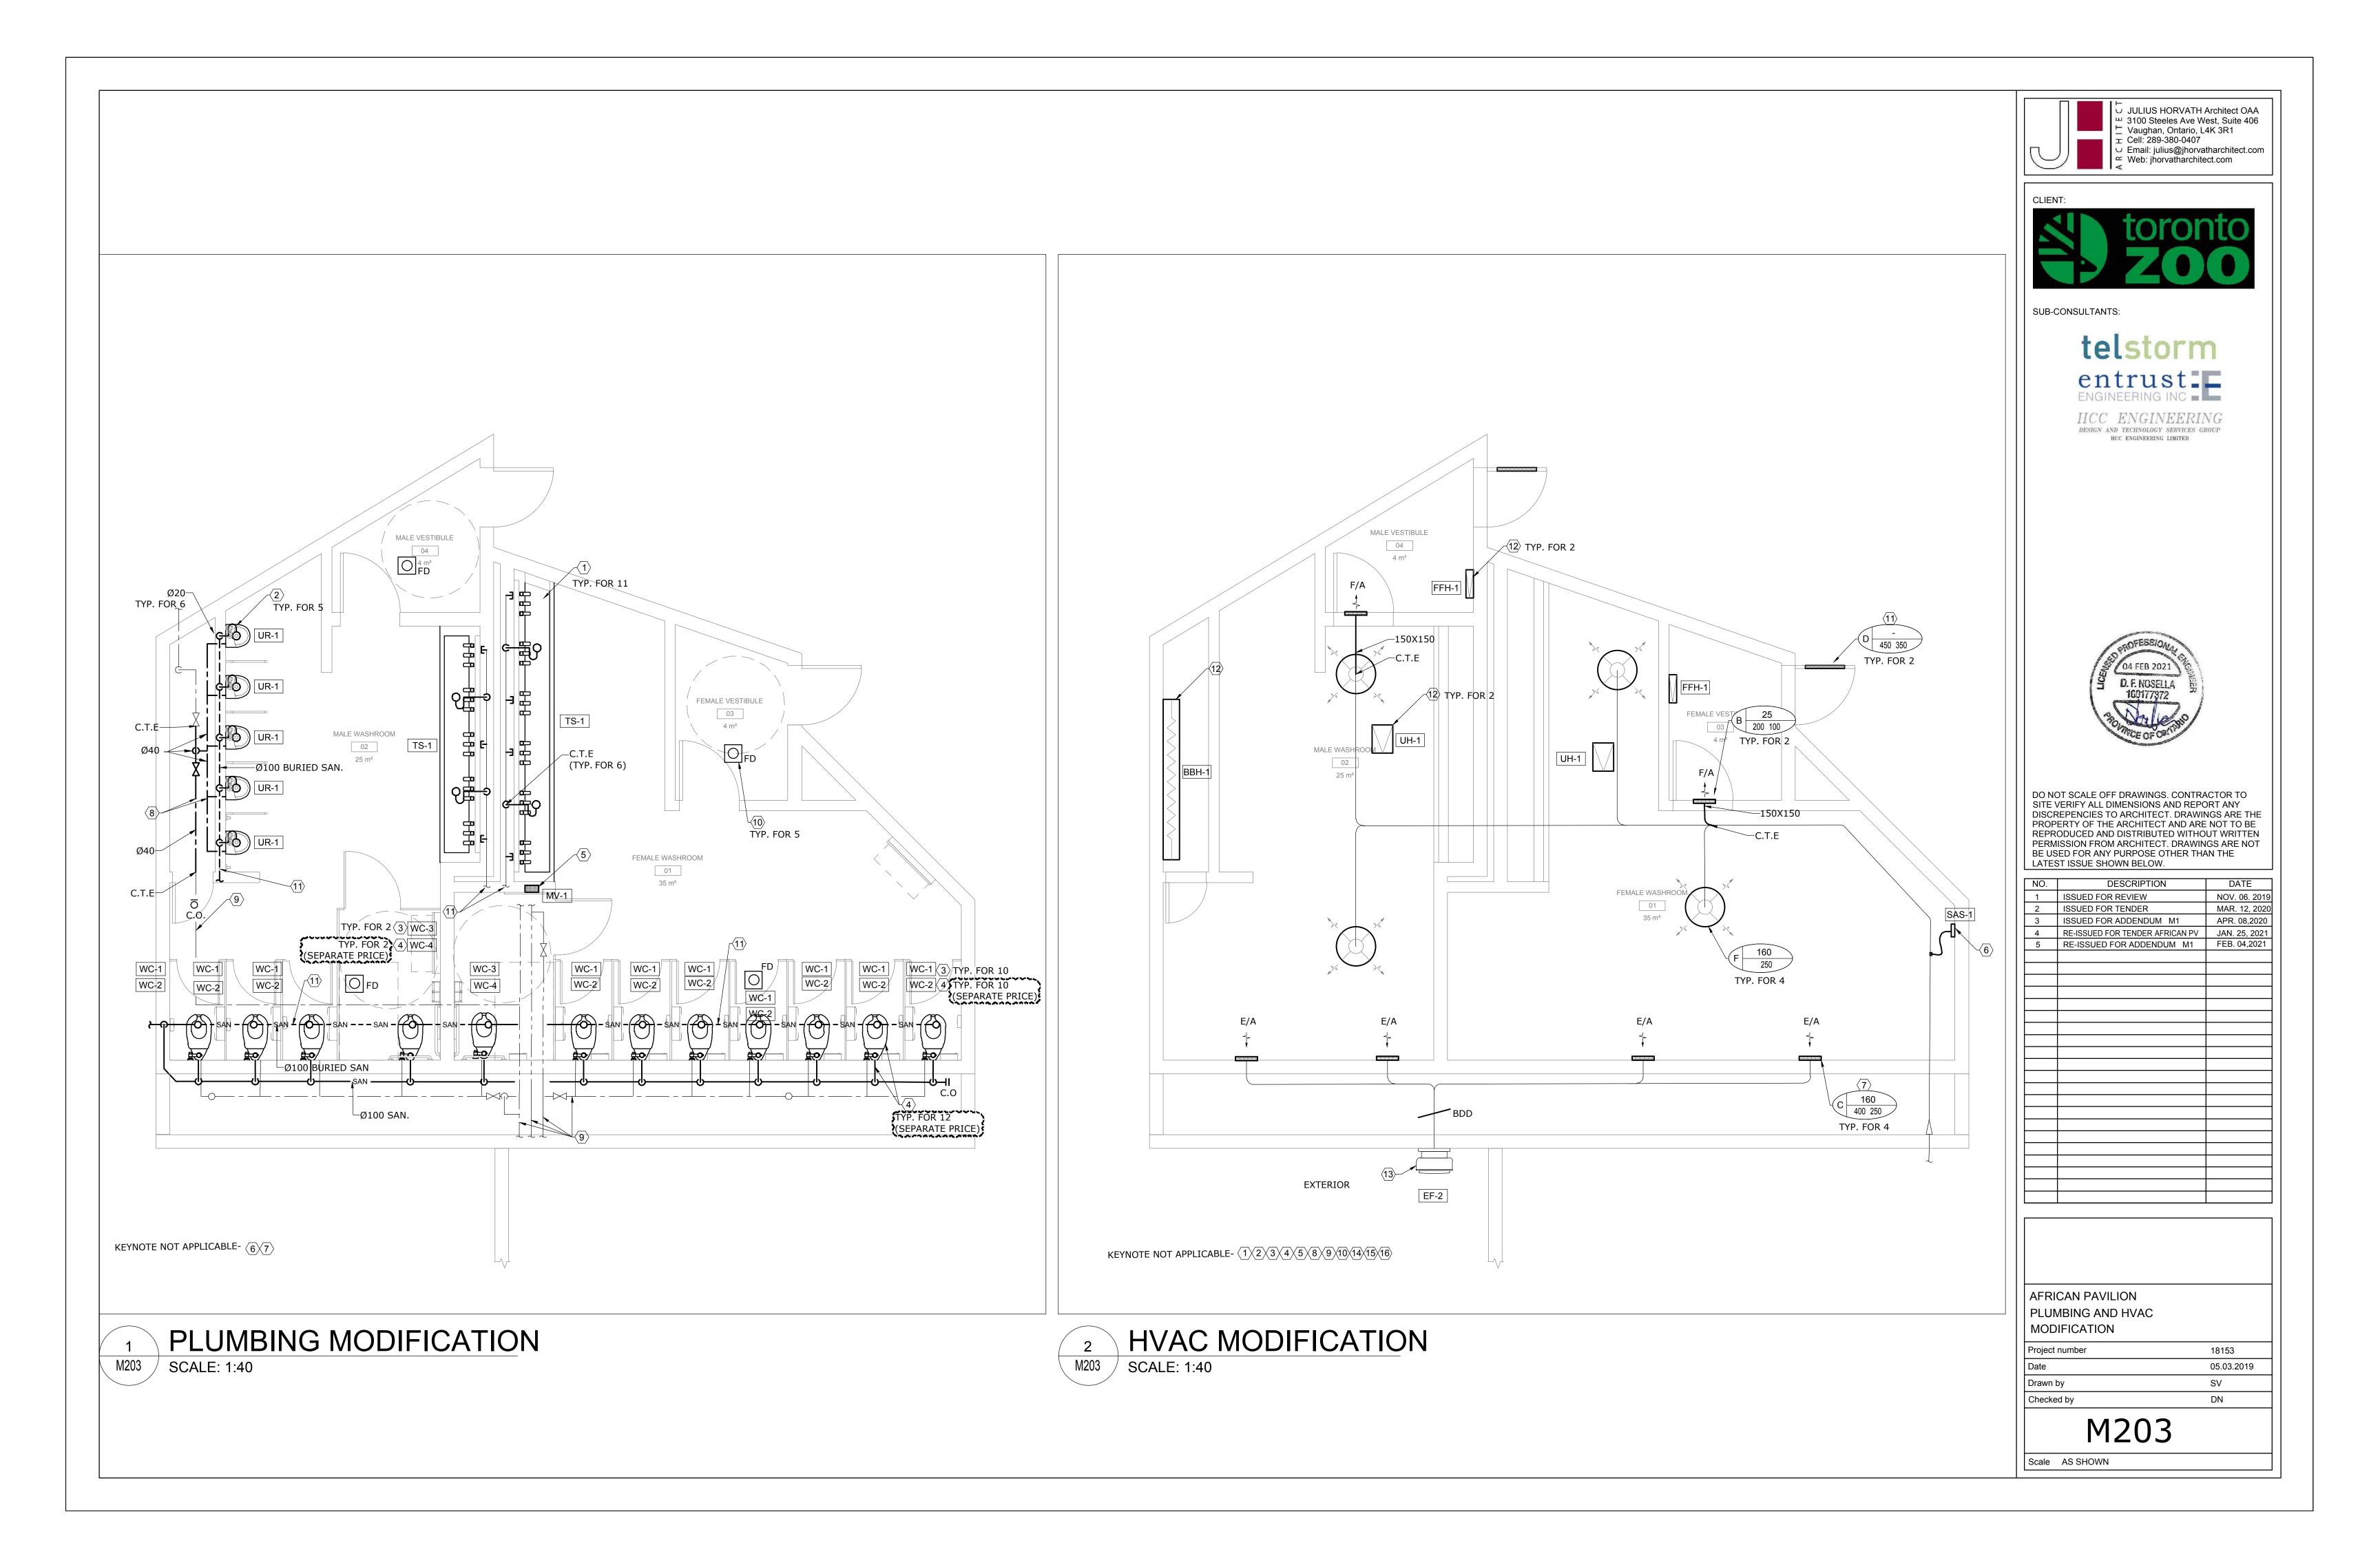

# HCC ENGINEERING LIMITED

Design and Technology Services Group 40 Eglinton Avenue East Suite 600 Toronto, Ontario M4P 3A2 Tel: (416) 932-2423

## Tender Addendum #E-01

Project:	WC Upgrades – African Pavilion
J	Toronto Zoo
	361A Old Finch Ave
	Toronto, Ontario


HCC Engineering Project No.: 19240 BCIN# 28954


Date:

**February 1, 2021** 

- 1. General
  - 1. This tender addendum is an integral part of the Specifications and Drawings and shall form an integral part of the Contract Documents.
- 2. Drawings
  - 1. Drawing No. E-2.0 (Reissued with Addendum)
  - 2. Drawing No. E-7.1 (Reissued with Addendum)


End of Tender Addendum #E-01

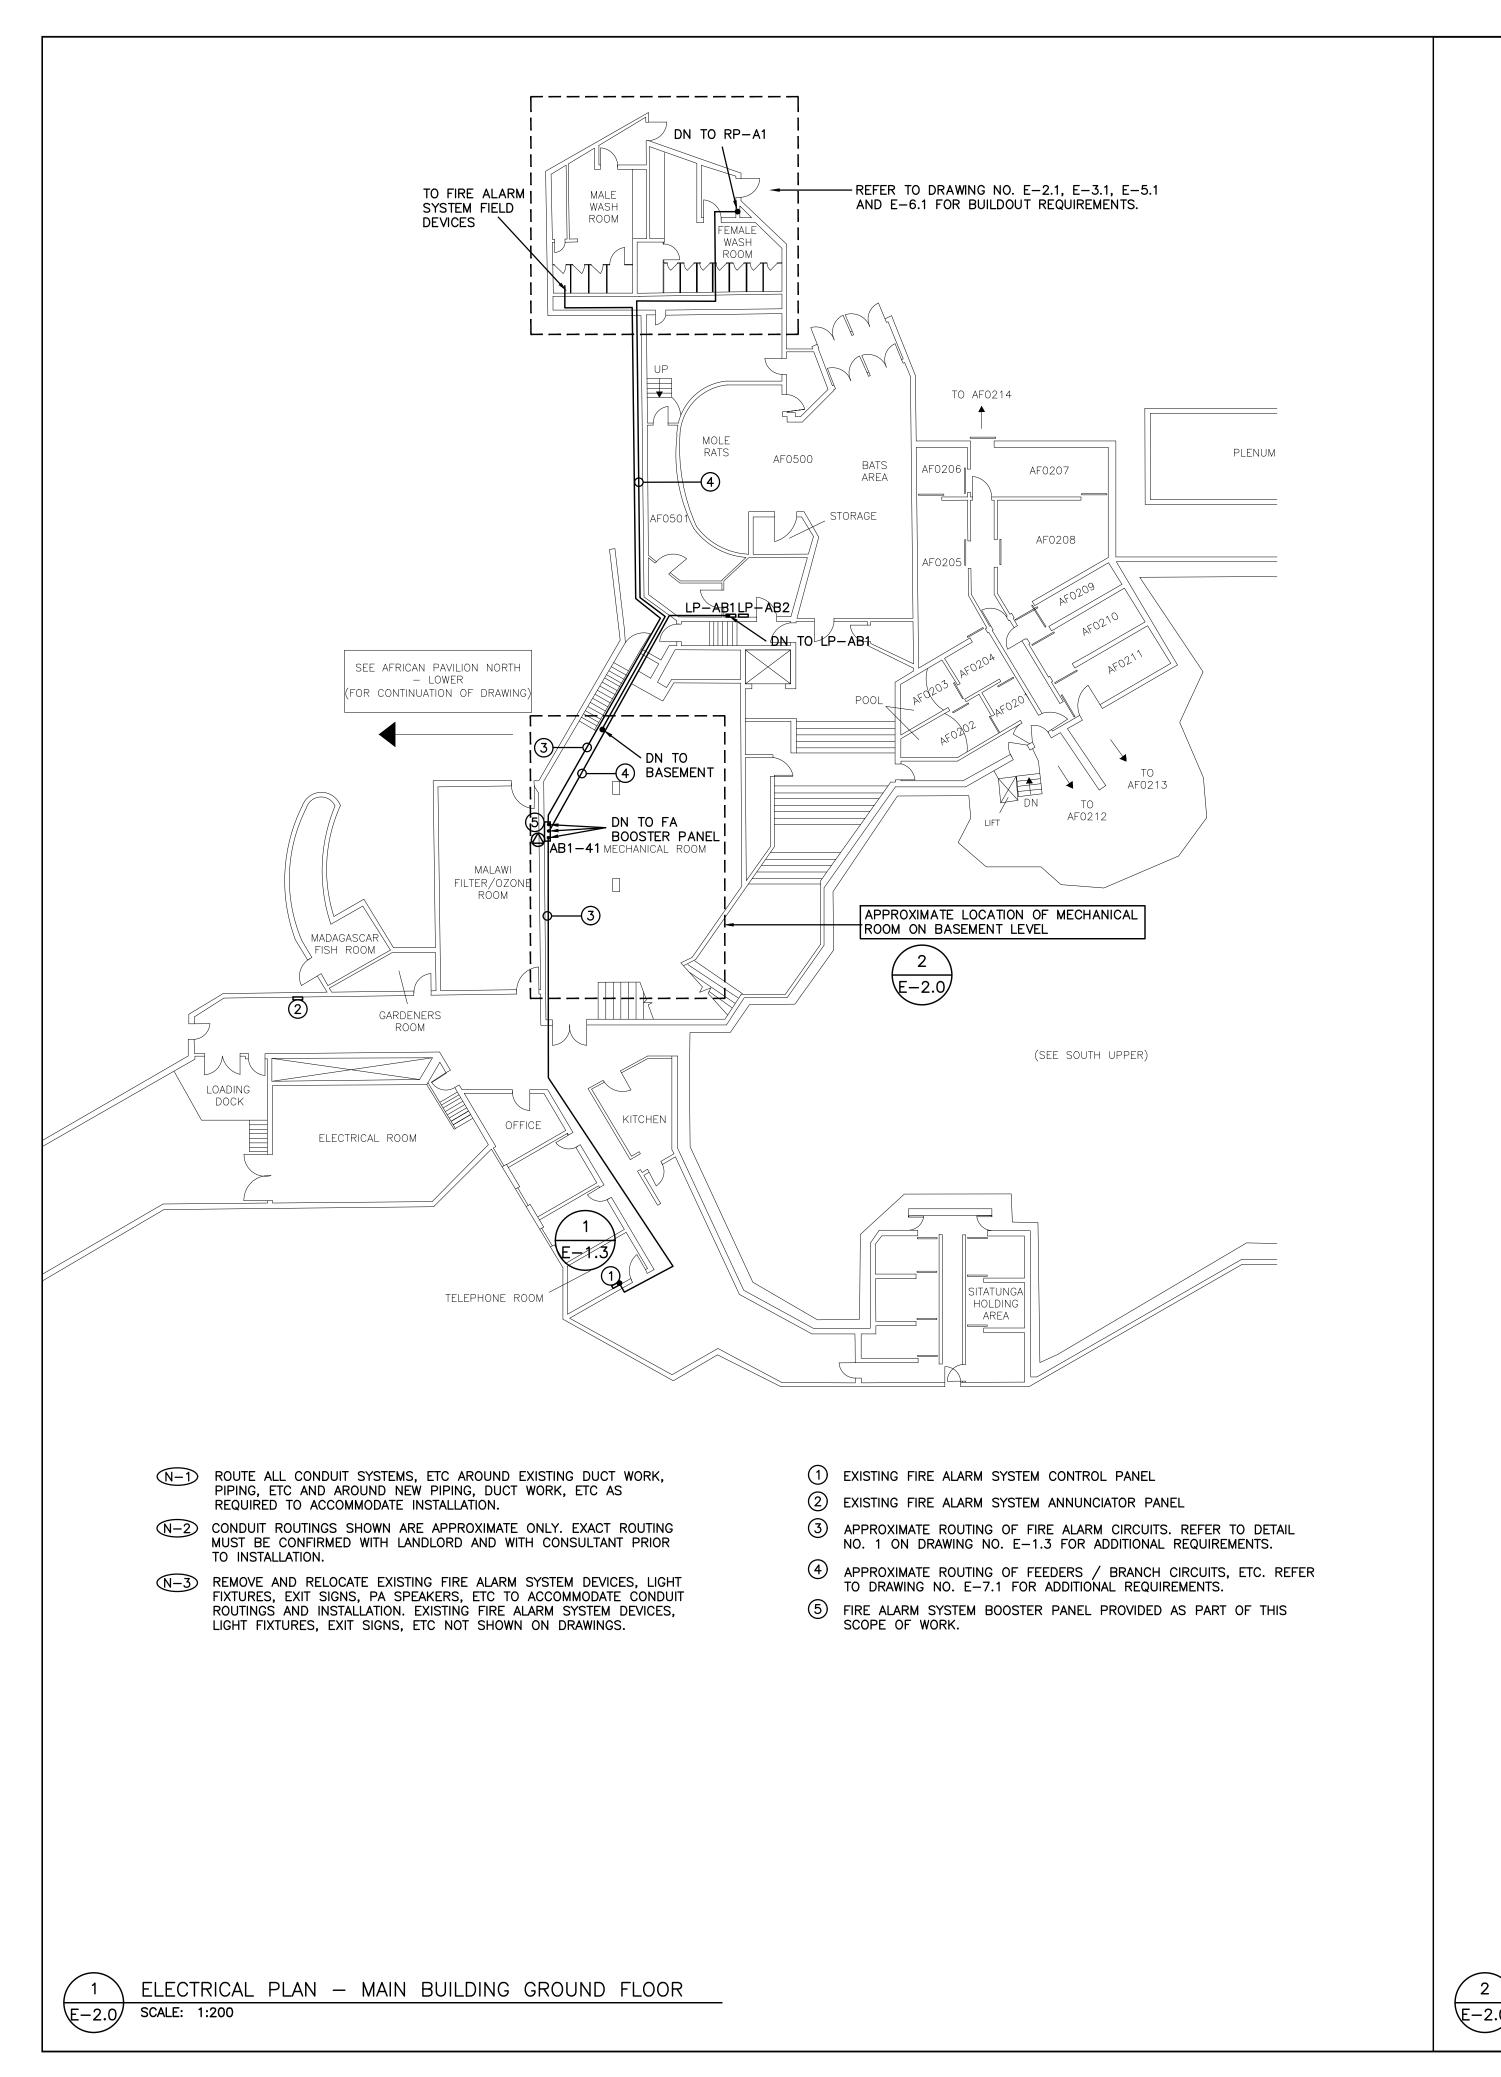

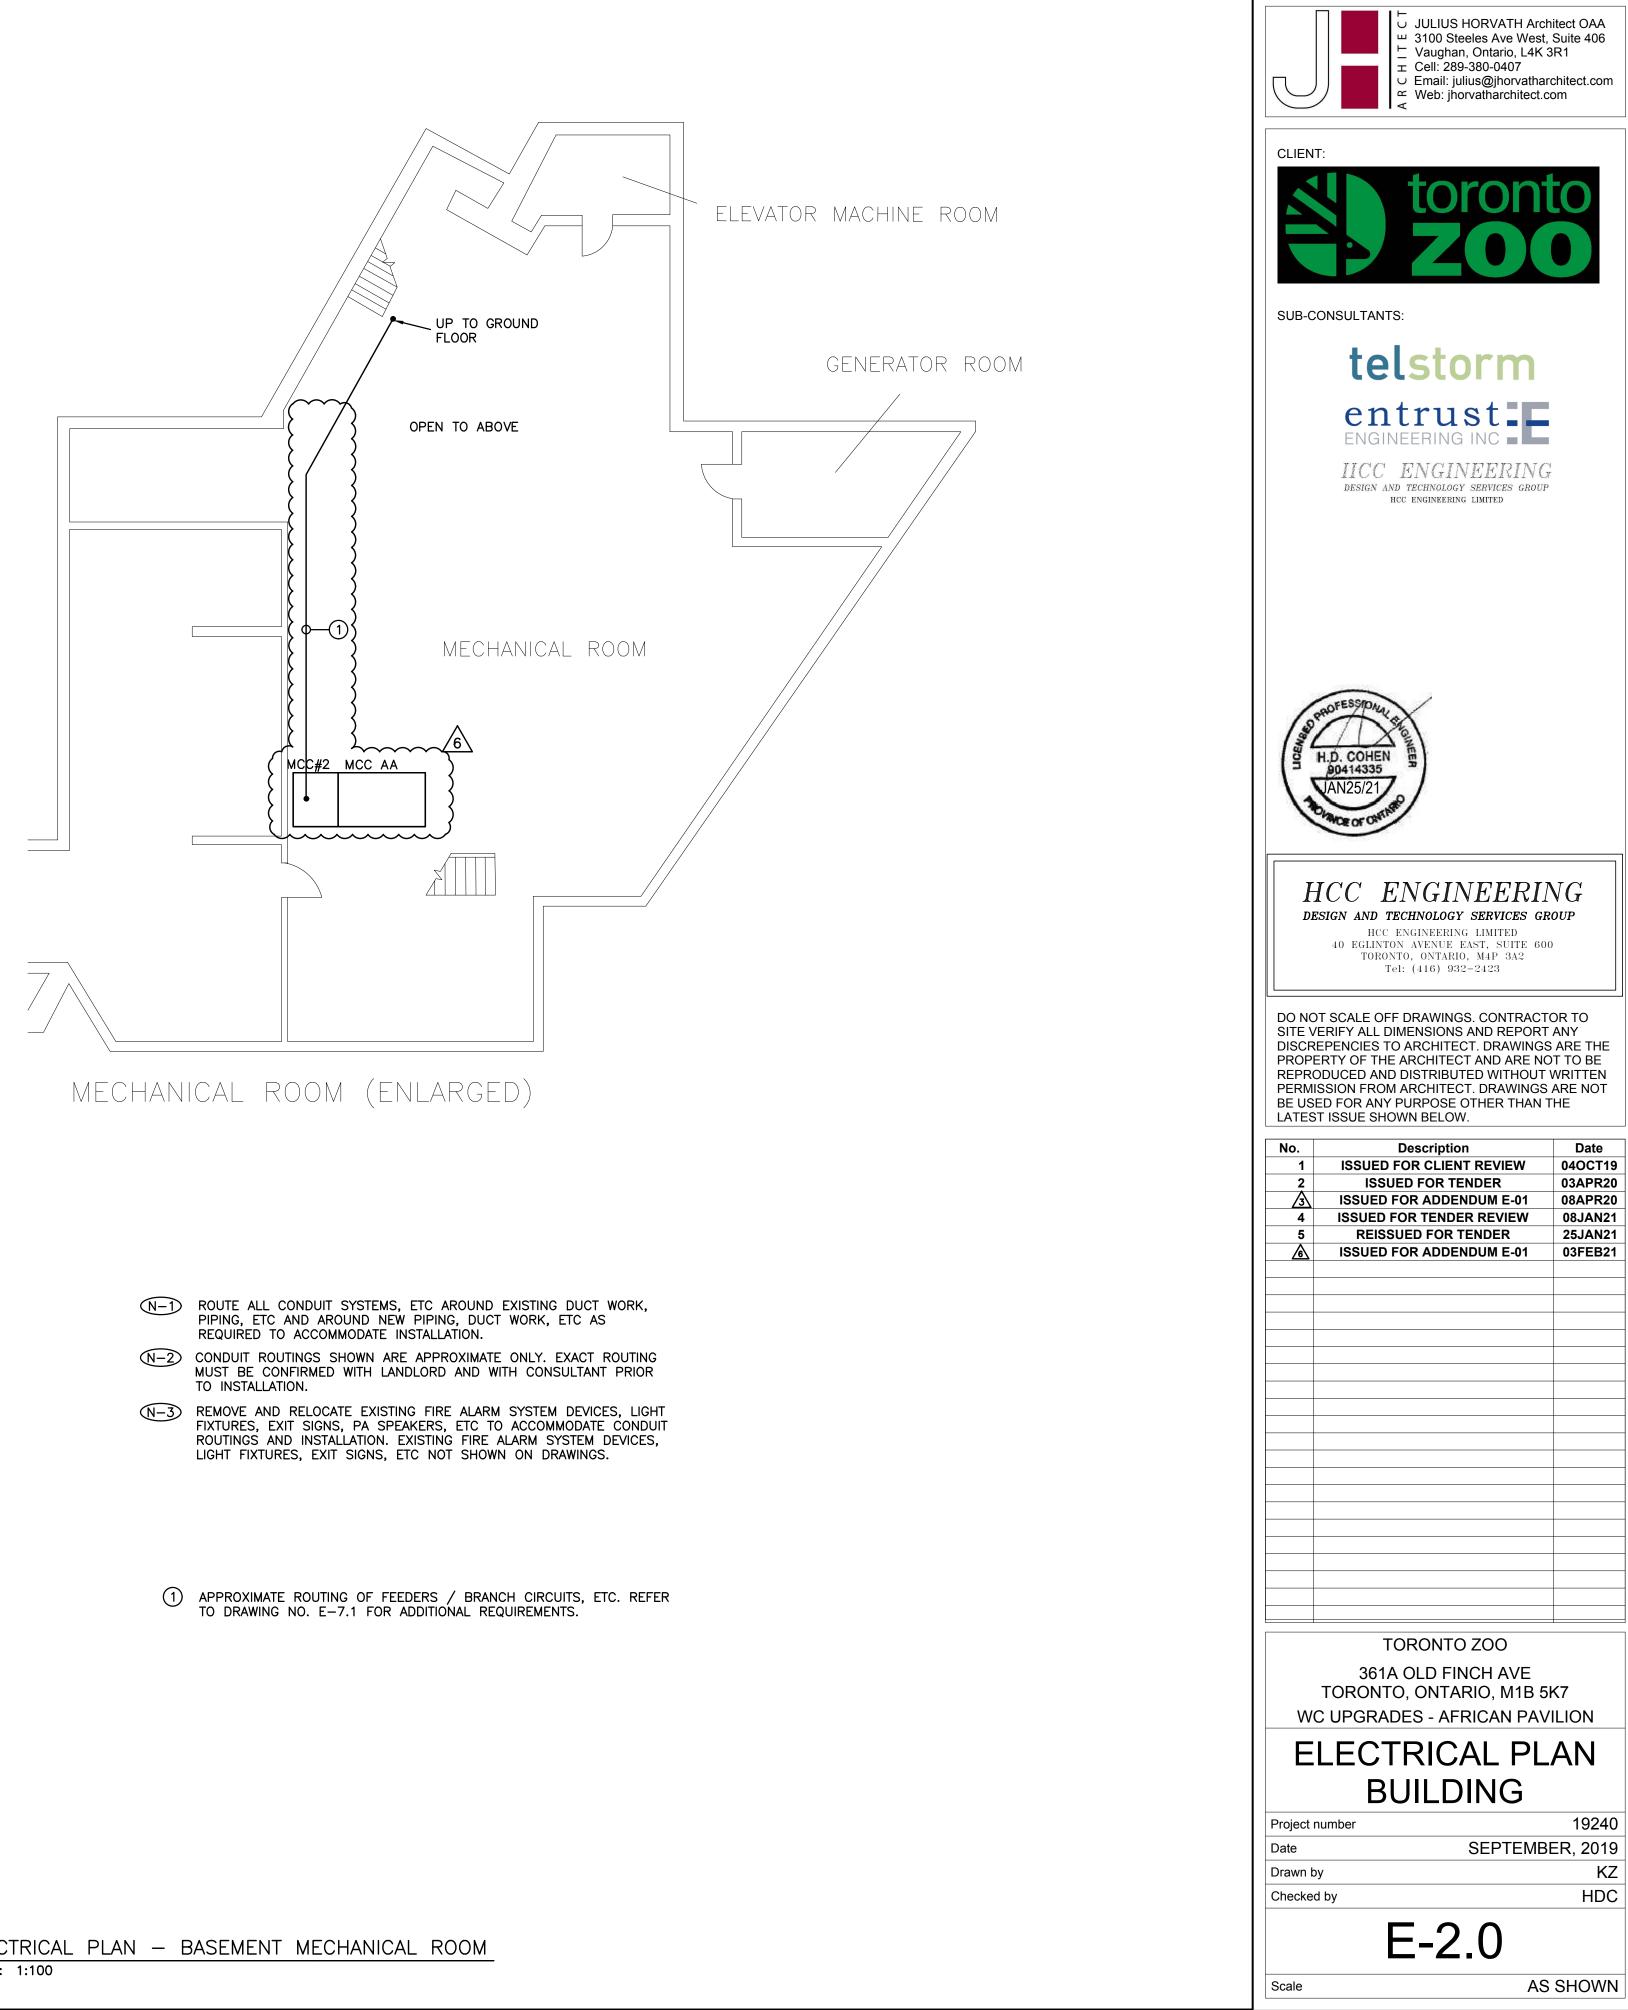


ELECTRICAL PLAN - BASEMENT MECHANICAL ROOM

E-2.0 SCALE: 1:100

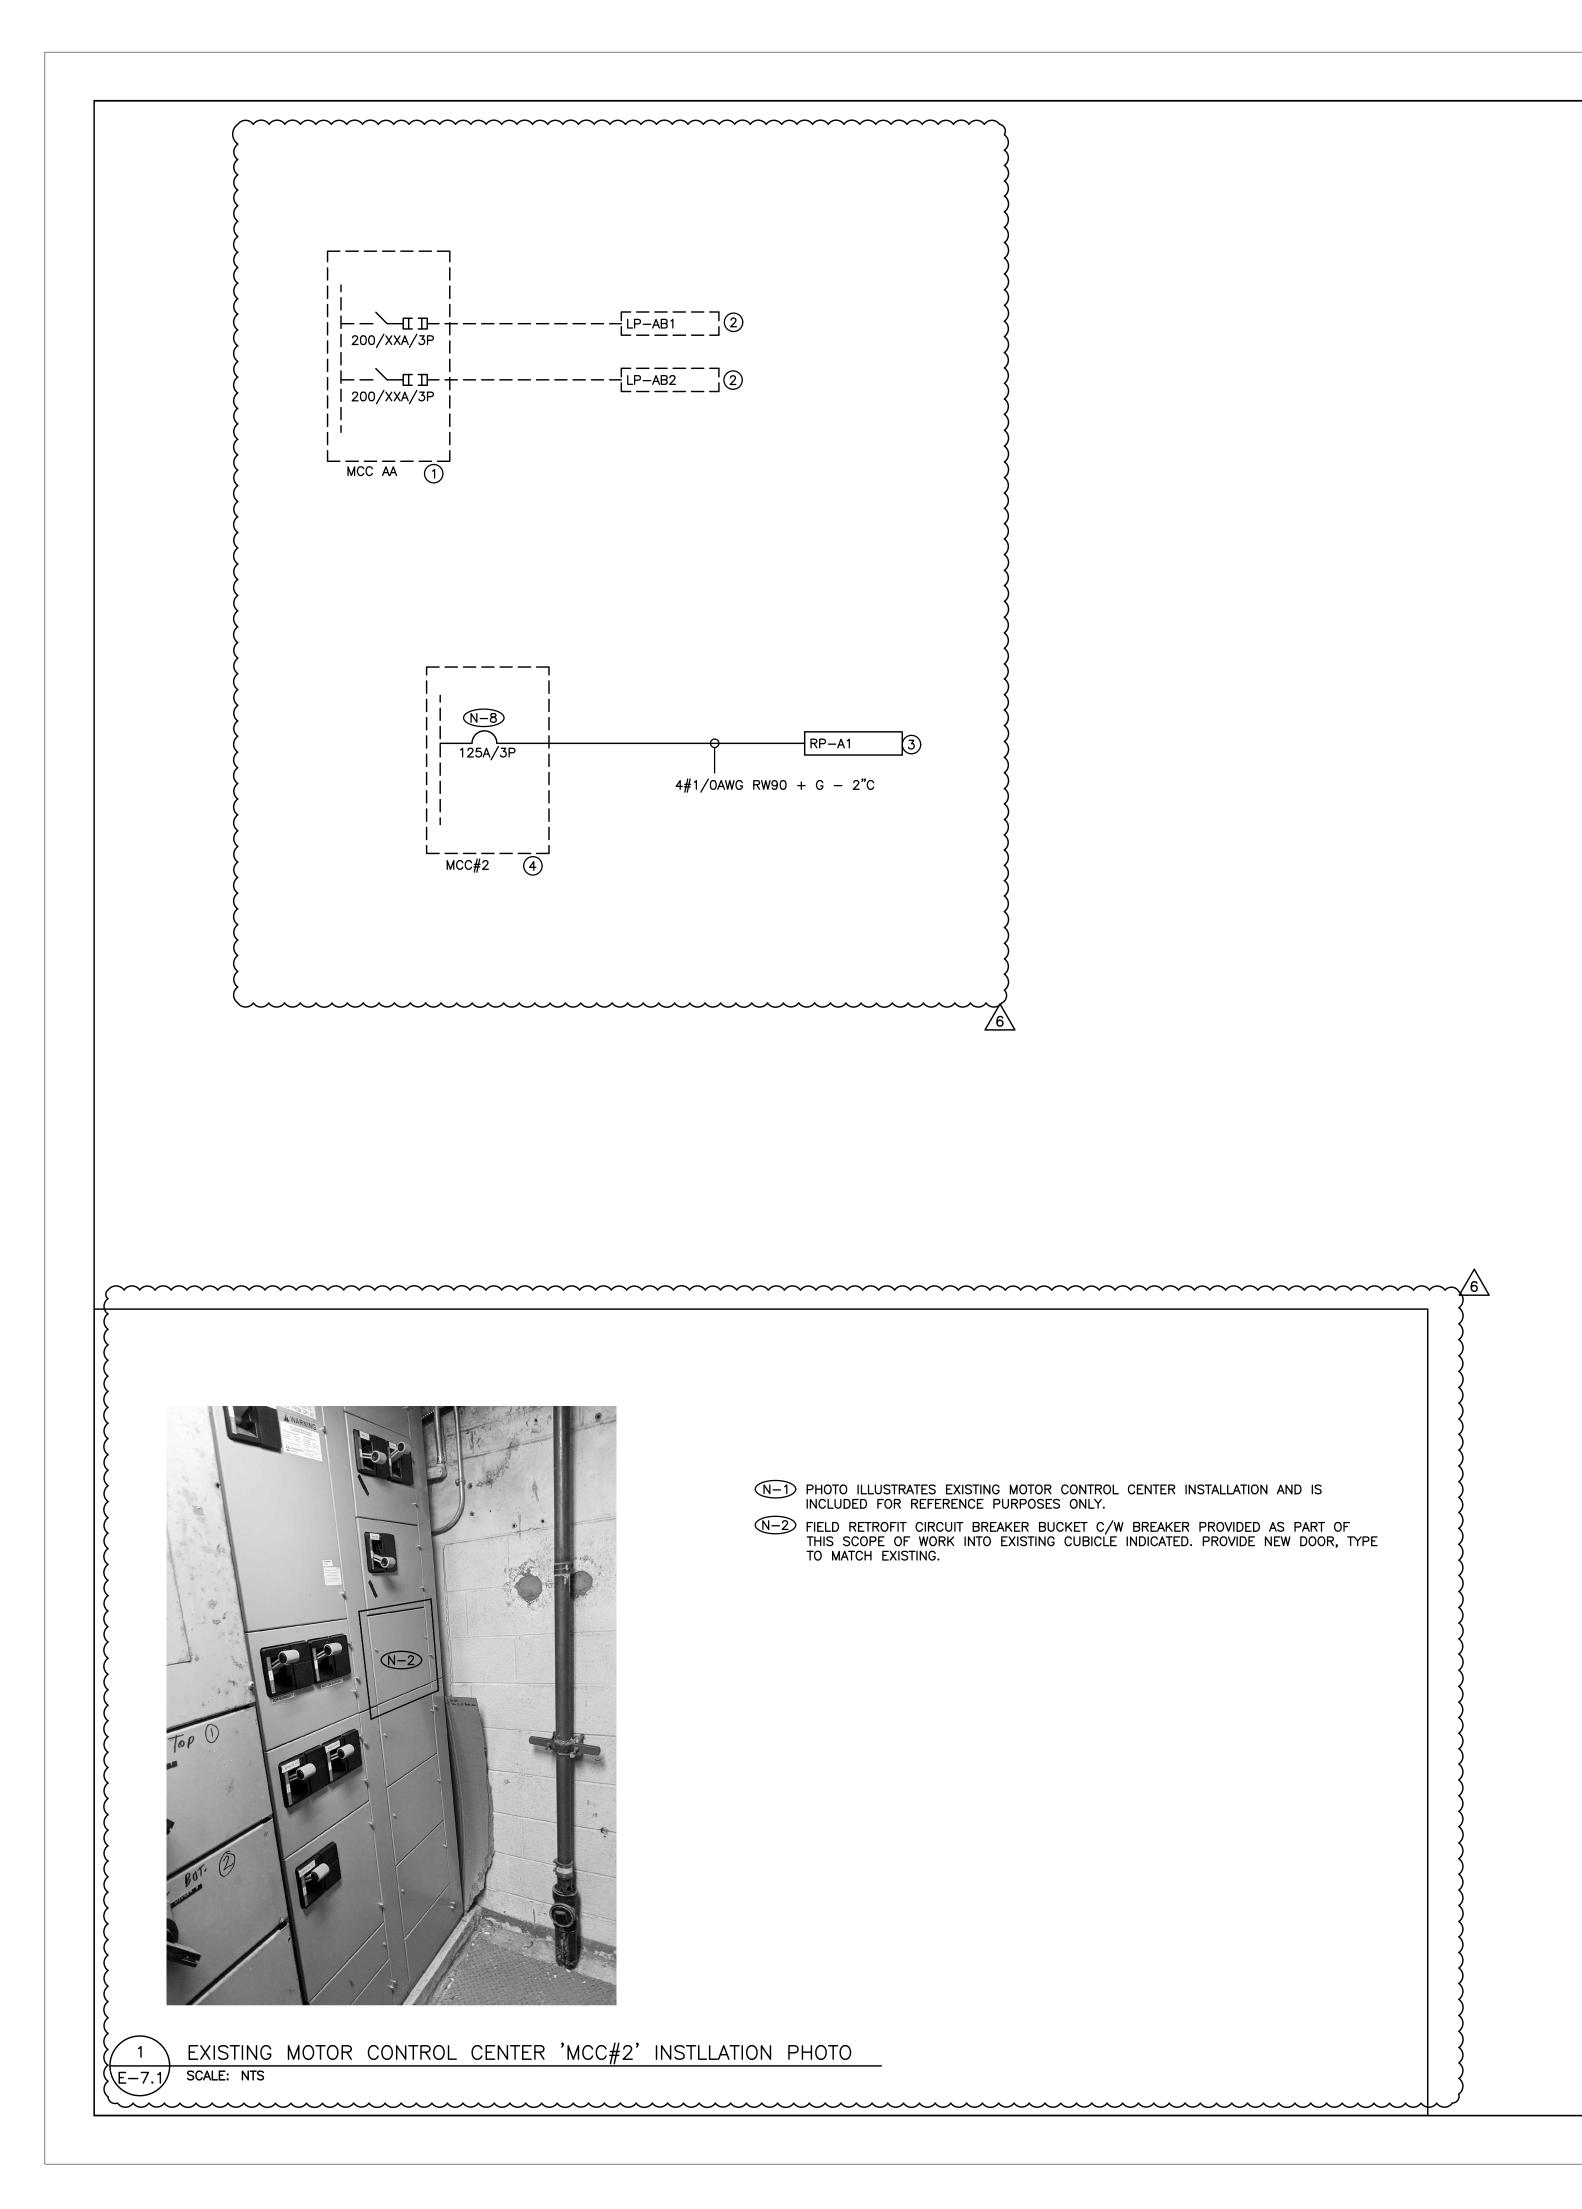

- N-1 RISER IS DIAGRAMMATIC ONLY. REFER TO FLOOR PLANS FOR DEVICE QUANTITY AND LOCATIONS. N-2 PROVIDE FIRE RATED PLYWOOD BACKBOARDS FOR ALL ELECTRICAL DISTRIBUTION EQUIPMENT PROVIDED AS PART OF THIS CONTRACT AND FOR ALL PREPURCHASED / PREQUALIFIED DISTRIBUTION. PAINT BACKBOARDS WITH FIRE RETARDANT PAINT (COLOUR AS DIRECTED ON SITE BY PROJECT MANAGER). FIRE RATED STAMP MUST BE ON ALL PIECES PROVIDED AND MUST BE VISIBLE WHEN INSTALLED. DO NOT PAINT OVER STAMP. N-3 ALL INDOOR DISTRIBUTION PROVIDED AS PART OF THIS SCOPE OF WORK MUST BE TYPE 2 ENCLOSURE, UNLESS SPECIFICALLY NOTED OTHERWISE. PROVIDE COMPRESSION FITTINGS FOR SERVICES ENTERING DISTRIBUTION. N-4) PROVIDE DEDICATED CORE DRILLED WALL AND FLOOR PENETRATIONS ON EVERY FLOOR. EXACT LOCATION OF ALL CORE DRILLS TO BE DETERMINED BY X-RAY RESULTS. ALL X-RAYS MUST BE REVIEWED AND APPROVED BY LANDLORD PRIOR TO CORE DRILLING. N-5 PROVIDE TEMPORARY POWER AND LIGHTING THROUGHOUT PROJECT TO ACCOMMODATE REQUIREMENTS OF ALL TRADES. REQUIREMENTS INCLUDE PROVIDING EXTENSION CORDS, EXTENSION LIGHTING AND EQUIPMENT REQUIRED FOR THE WORK OF ALL TRADES. ALL COSTS RELATED TO THIS WORK SHALL BE INCLUDED IN THE BASE BID PRICE. N-6 ROUTE ALL CONDUIT SYSTEMS AROUND EXISTING DUCT WORK, BEAMS, NEW DUCT WORK AND PIPING AS REQUIRED TO ACCOMMODATE CONDUIT SYSTEM INSTALLATION. REFER TO MECHANICAL DRAWINGS AND DESIGNER DRAWINGS FOR ADDITIONAL DETAILS. (N-7) ALL BREAKERS REQUIRED TO COMPLETE ALL SCOPES OF WORK TO BE NEW. DO NOT REUSE EXISTING BREAKERS. N-B PROVIDE NEW CIRCUIT BREAKER BUCKET C/W BREAKER INDICATED. PROVIDE REPLACEMENT PARTS, DOOR, MOUNTING HARDWARE, CONN KITS, FILLER PLATES, PRE-FABBED MCC BUS LINKS, ETC., TO ACCOMMODATE INSTALLATION AND FOR MODIFYING EXISTING PANEL BUS.
- WORK. REFER TO DETAIL NO. 1 ON DRAWING E-7.1 FOR ADDITIONAL REQUIREMENTS.
- (1) EXISTING MOTOR CONTROL CENTER 120/208V/3PH/4W/SIEMENS MODEL 8PG02 MOTOR CONTROL CENTRE/100KA RMS (2) EXISTING RECEPTACLE PANEL – 120/208V/3PH/4W/225A MAINS/42CCT/FEDERAL PACIFIC
- (3) RECEPTACLE PANEL 120/208V/3PH/4W/125A MCB/COPPER BUS/84CCT 20"W/BASIS OF DESIGN SIEMENS P2 OR SCHNEIDER SQ D NQ/10KA RMS SERIES RATED/RECESSED TRIM FACTORY PAINTED CUSTOM COLOUR (MATCH TO PAINT CHIP TO BE PROVIDED BY INTERIOR ARCHITECT DURING CONSTRUCTION)
- (4) EXISTING MOTOR CONTROL CENTER 120/208V/3PH/4W/EATON CUTLER-HAMMER MOTOR CONTROL CENTRE/65KA RMS

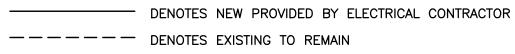

\* - X - X - X - X DENOTES EXISTING TO BE REMOVED BY ELECTRICAL CONTRACTOR

ELECTRICAL CONTRACTOR TO PREPARE A PRELIMINARY ZERO FEEDER LENGTH COORDINATION STUDY PRIOR TO ORDERING DISTRIBUTION. SUBMIT TO CONSULTANT FOR **REVIEW AND APPROVAL.** 

